


DATE	REV	REVISION DESCRIPTION
APRIL 8, 2003		

DESIGNED BY: J.E. G.W., K.K.
DRAWN BY: H.D. G.K., G.Y.
PROFESSION: ARCHITECTURE
PROJECT ARCHITECT: RICHARD R. HELTON
H.M.A. PROJECT NUMBER: 200544

RECORD SET
JANUARY 17, 06

SHEET TITLE:
GROUND LEVEL PLAN

SHEET NUMBER:
A1.1

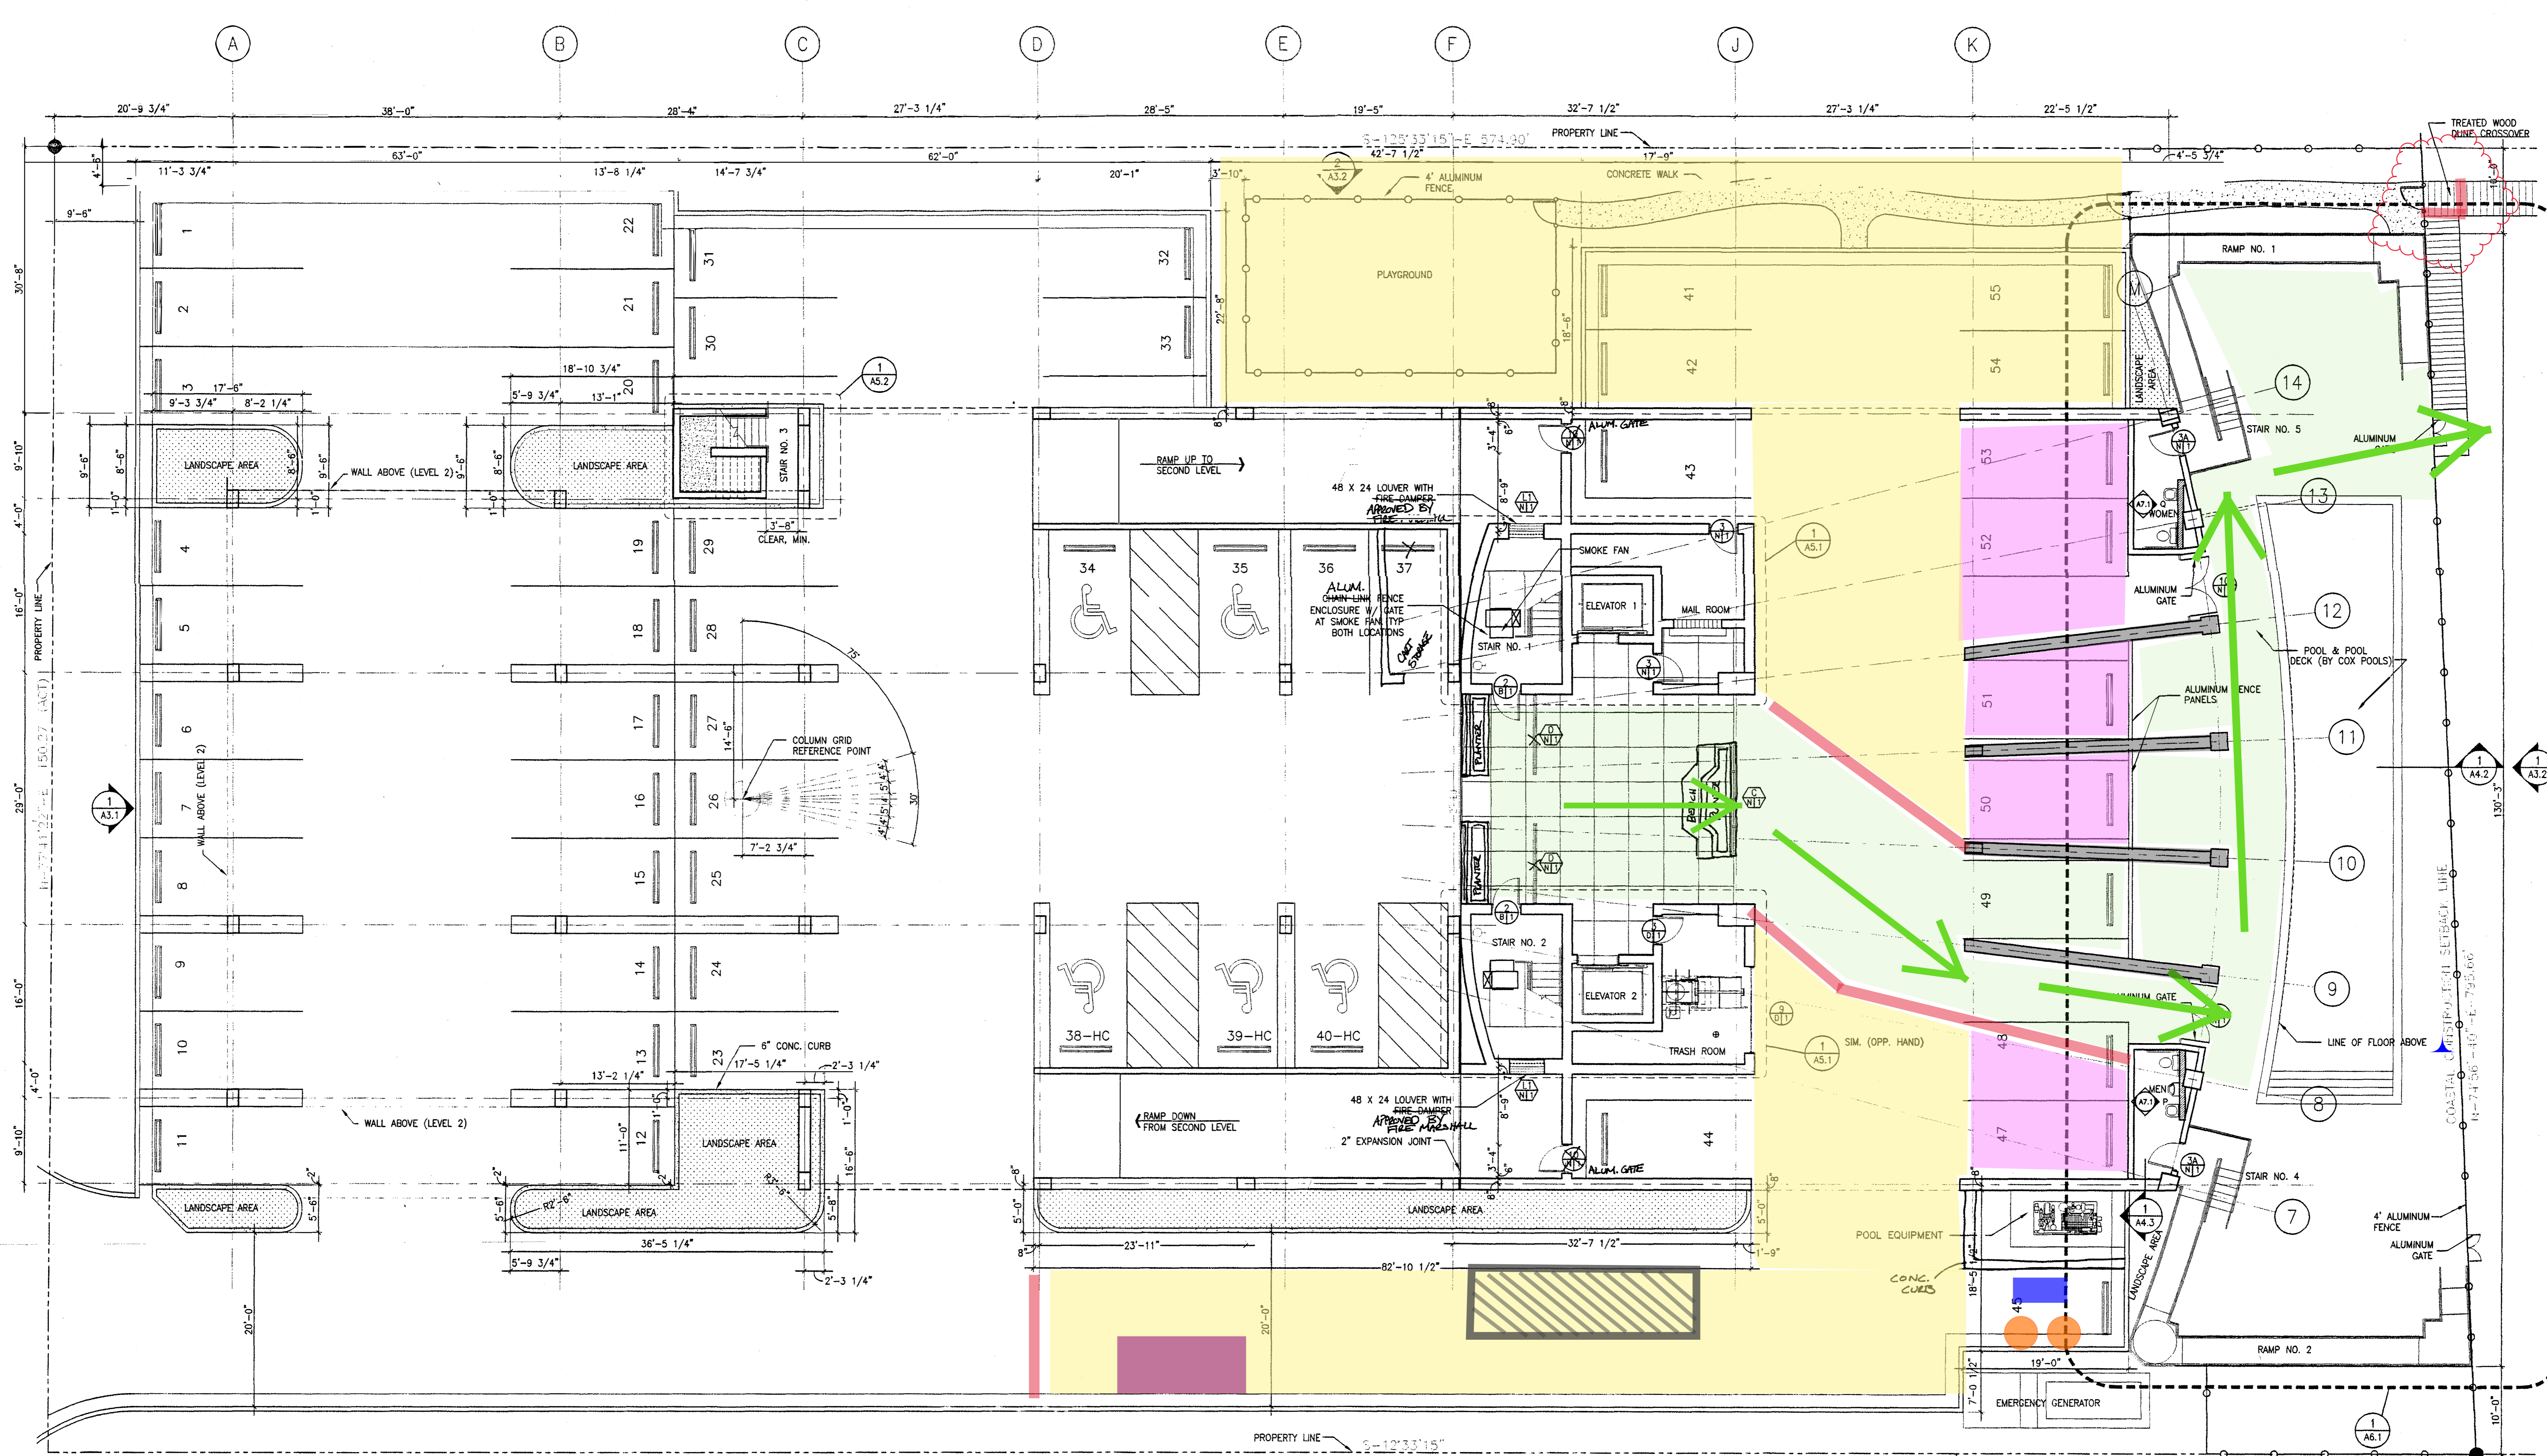

- INDEX**
- Beach Access
 - Barricade
 - Toilet
 - Closed (Phase 1)
 - Dumpster
 - Hand Wash
 - Storage
 - Fire lane

GROUND LEVEL PLAN
SCALE: 1/8"=1'-0"
REFERENCE ELEVATION = 0'-0"
ACTUAL ELEVATION = 9'-11" (REFER TO CIVIL DRAWINGS)

NOTE:
SEE STRUCTURAL DRAWINGS FOR DIMENSIONS AND LOCATIONS OF CAST CONCRETE WALLS, COLUMNS, SLABS, ETC.
CONTRACTOR SHALL IMMEDIATELY NOTIFY ARCHITECT OF ANY DISCREPANCIES IN DIMENSION BETWEEN ARCHITECTURAL AND STRUCTURAL DRAWINGS.

ARCHITECTURAL NOTES

- METHOD FOR DIMENSIONING WALLS AND OPENING:
- CONCRETE & MASONRY WALLS: FACE TO FACE
- EXTERIOR FRAME WALL: FACE OF STUDS AND CENTER OF OPENING.
- INTERIOR FRAME PARTITION: CENTERLINE OF STUDS.
UNLESS NOTED OTHERWISE.
- ALL INTERIOR DOORS SHALL BE 4" OFFSET FROM FINISH OF STUD WALL AND 8" OFFSET FROM CMU WALL, UNLESS NOTED OTHERWISE.
- GENERAL CONTRACTOR SHALL COORDINATE THE LOCATION OF REQUIRED BLOCKING IN WALLS TO RECEIVE CABINETS, SHELVING, TOILET ACCESSORIES, ETC.
- PROVIDE SPECIFIED SUBSTRATE BOARD AT ALL BATHROOMS TOILET ROOMS AND JANITOR ROOMS. UNLESS NOTED OTHERWISE.
- WORD "ALIGN" INDICATES ALIGN FINISH FACE OF WALLS, UNLESS NOTED OTHERWISE.
FLUSH MOUNTED
WORD "FEC" INDICATES FULLY RECESSED FIRE EXTINGUISHER CABINET W/ FIRE EXT.
- REFER TO CIVIL STRUCTURAL, MECHANICAL AND ELECTRICAL DRAWINGS FOR ADDITIONAL INFORMATION.
- REFER TO COVER SHEET FOR TYPICAL ARCHITECTURAL LEGEND.
- ALL PENETRATIONS THROUGH FIRE ASSEMBLIES SHALL HAVE APPROPRIATE FIRESTOPPING.
- DETAILS LABELED "TYPICAL DETAILS" ON THE DRAWINGS APPLY TO ALL SITUATIONS THAT ARE THE SAME OR SIMILAR TO THOSE SPECIFICALLY DETAILED. SUCH DETAILS APPLY WHETHER OR NOT THEY ARE KEYPED IN AT EACH LOCATION. QUESTIONS REGARDING APPLICABILITY OF TYPICAL DETAILS SHALL BE RESOLVED BY THE ARCHITECT OR ENGINEER.
- REFER TO LIFE SAFETY SHEET, AD, FOR TYPES AND LOCATIONS OF RATED WALL ASSEMBLIES, FIRE EXTINGUISHER LOCATIONS, AND MEANS OF EGRESS.
- NUMBERED PARKING SPACES ARE FOR REFERENCE PURPOSES ONLY. NO SPACES ARE "ASSIGNED" TO ANY UNIT.

LEGEND

- INDICATES LANDSCAPE PLANTING BED
- PAINTED PARKING AISLE STRIPING PER ADA GUIDELINES.

Floor Plans

This drawing is the property of Hatch Mott MacDonald Alabama, LLC, and may not be reproduced without written permission.